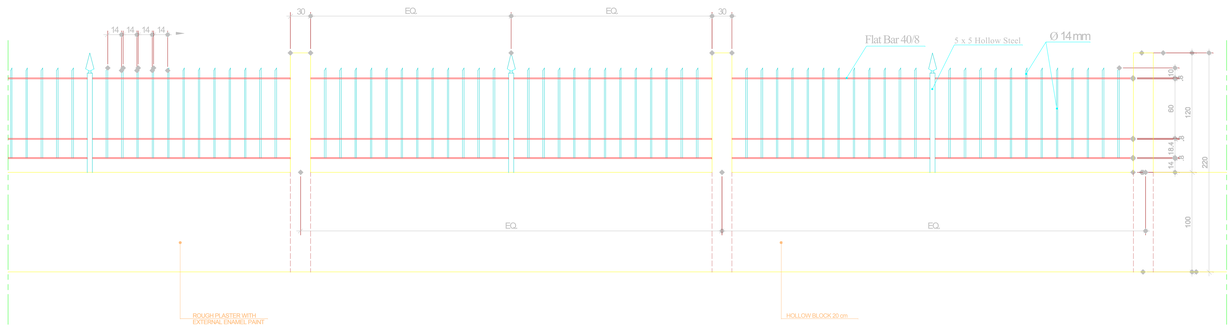

FENCE WALL DETAIL TYPE (1) 8
SCALE 1/20

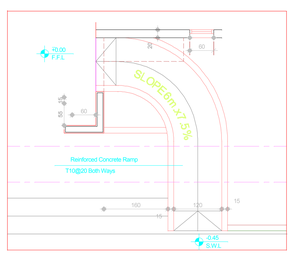

5a PLAN
SCALE: 1/50

SECTION HANDRAIL
SCALE: 1/10

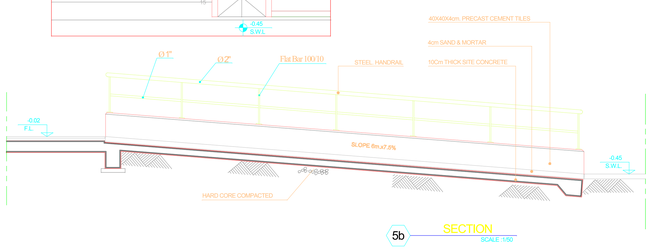

5b SECTION
SCALE: 1/50

SECTION FOR TYPICAL RAMP
SCALE: 1/20

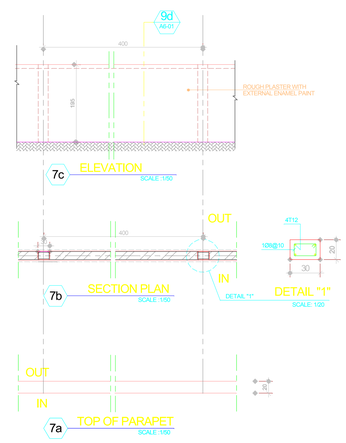

7c ELEVATION
SCALE: 1/50

7b SECTION PLAN
SCALE: 1/50

DETAIL "1"
SCALE: 1/20

7a TOP OF PARAPET
SCALE: 1/50

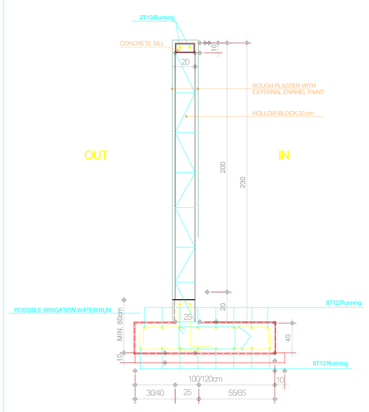

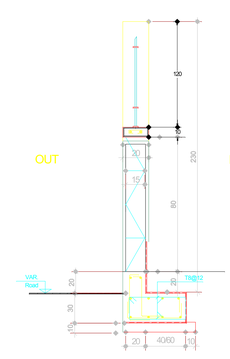

SOLUTION 5
Where Applicable Between Axis A & F

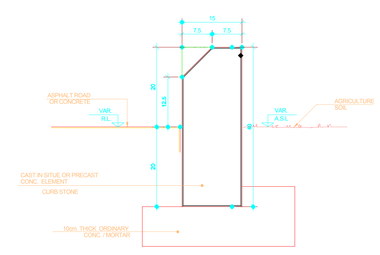

General Construction & Contracting Co.
DAR-AL HABIB
tripoli, Lebanon Tel:03/565814

KALAMOUN
PUBLIC GARDEN-16
NORTH - LEBANON

AS BUILT DRAWING

ARCHITECTURAL WORKS

FENCE DETAILS

DRAWN BY: S.K.
DESIGN BY: M.
CHECKED BY: GAMBERINI
GIULIO
APPROVED BY:
ISSUED FOR: A AS BUILT
ISSUED FOR: B 0.1 D.A.
ISSUED FOR: C 0 BUID
DATE REMARK
TYP. SCALE